
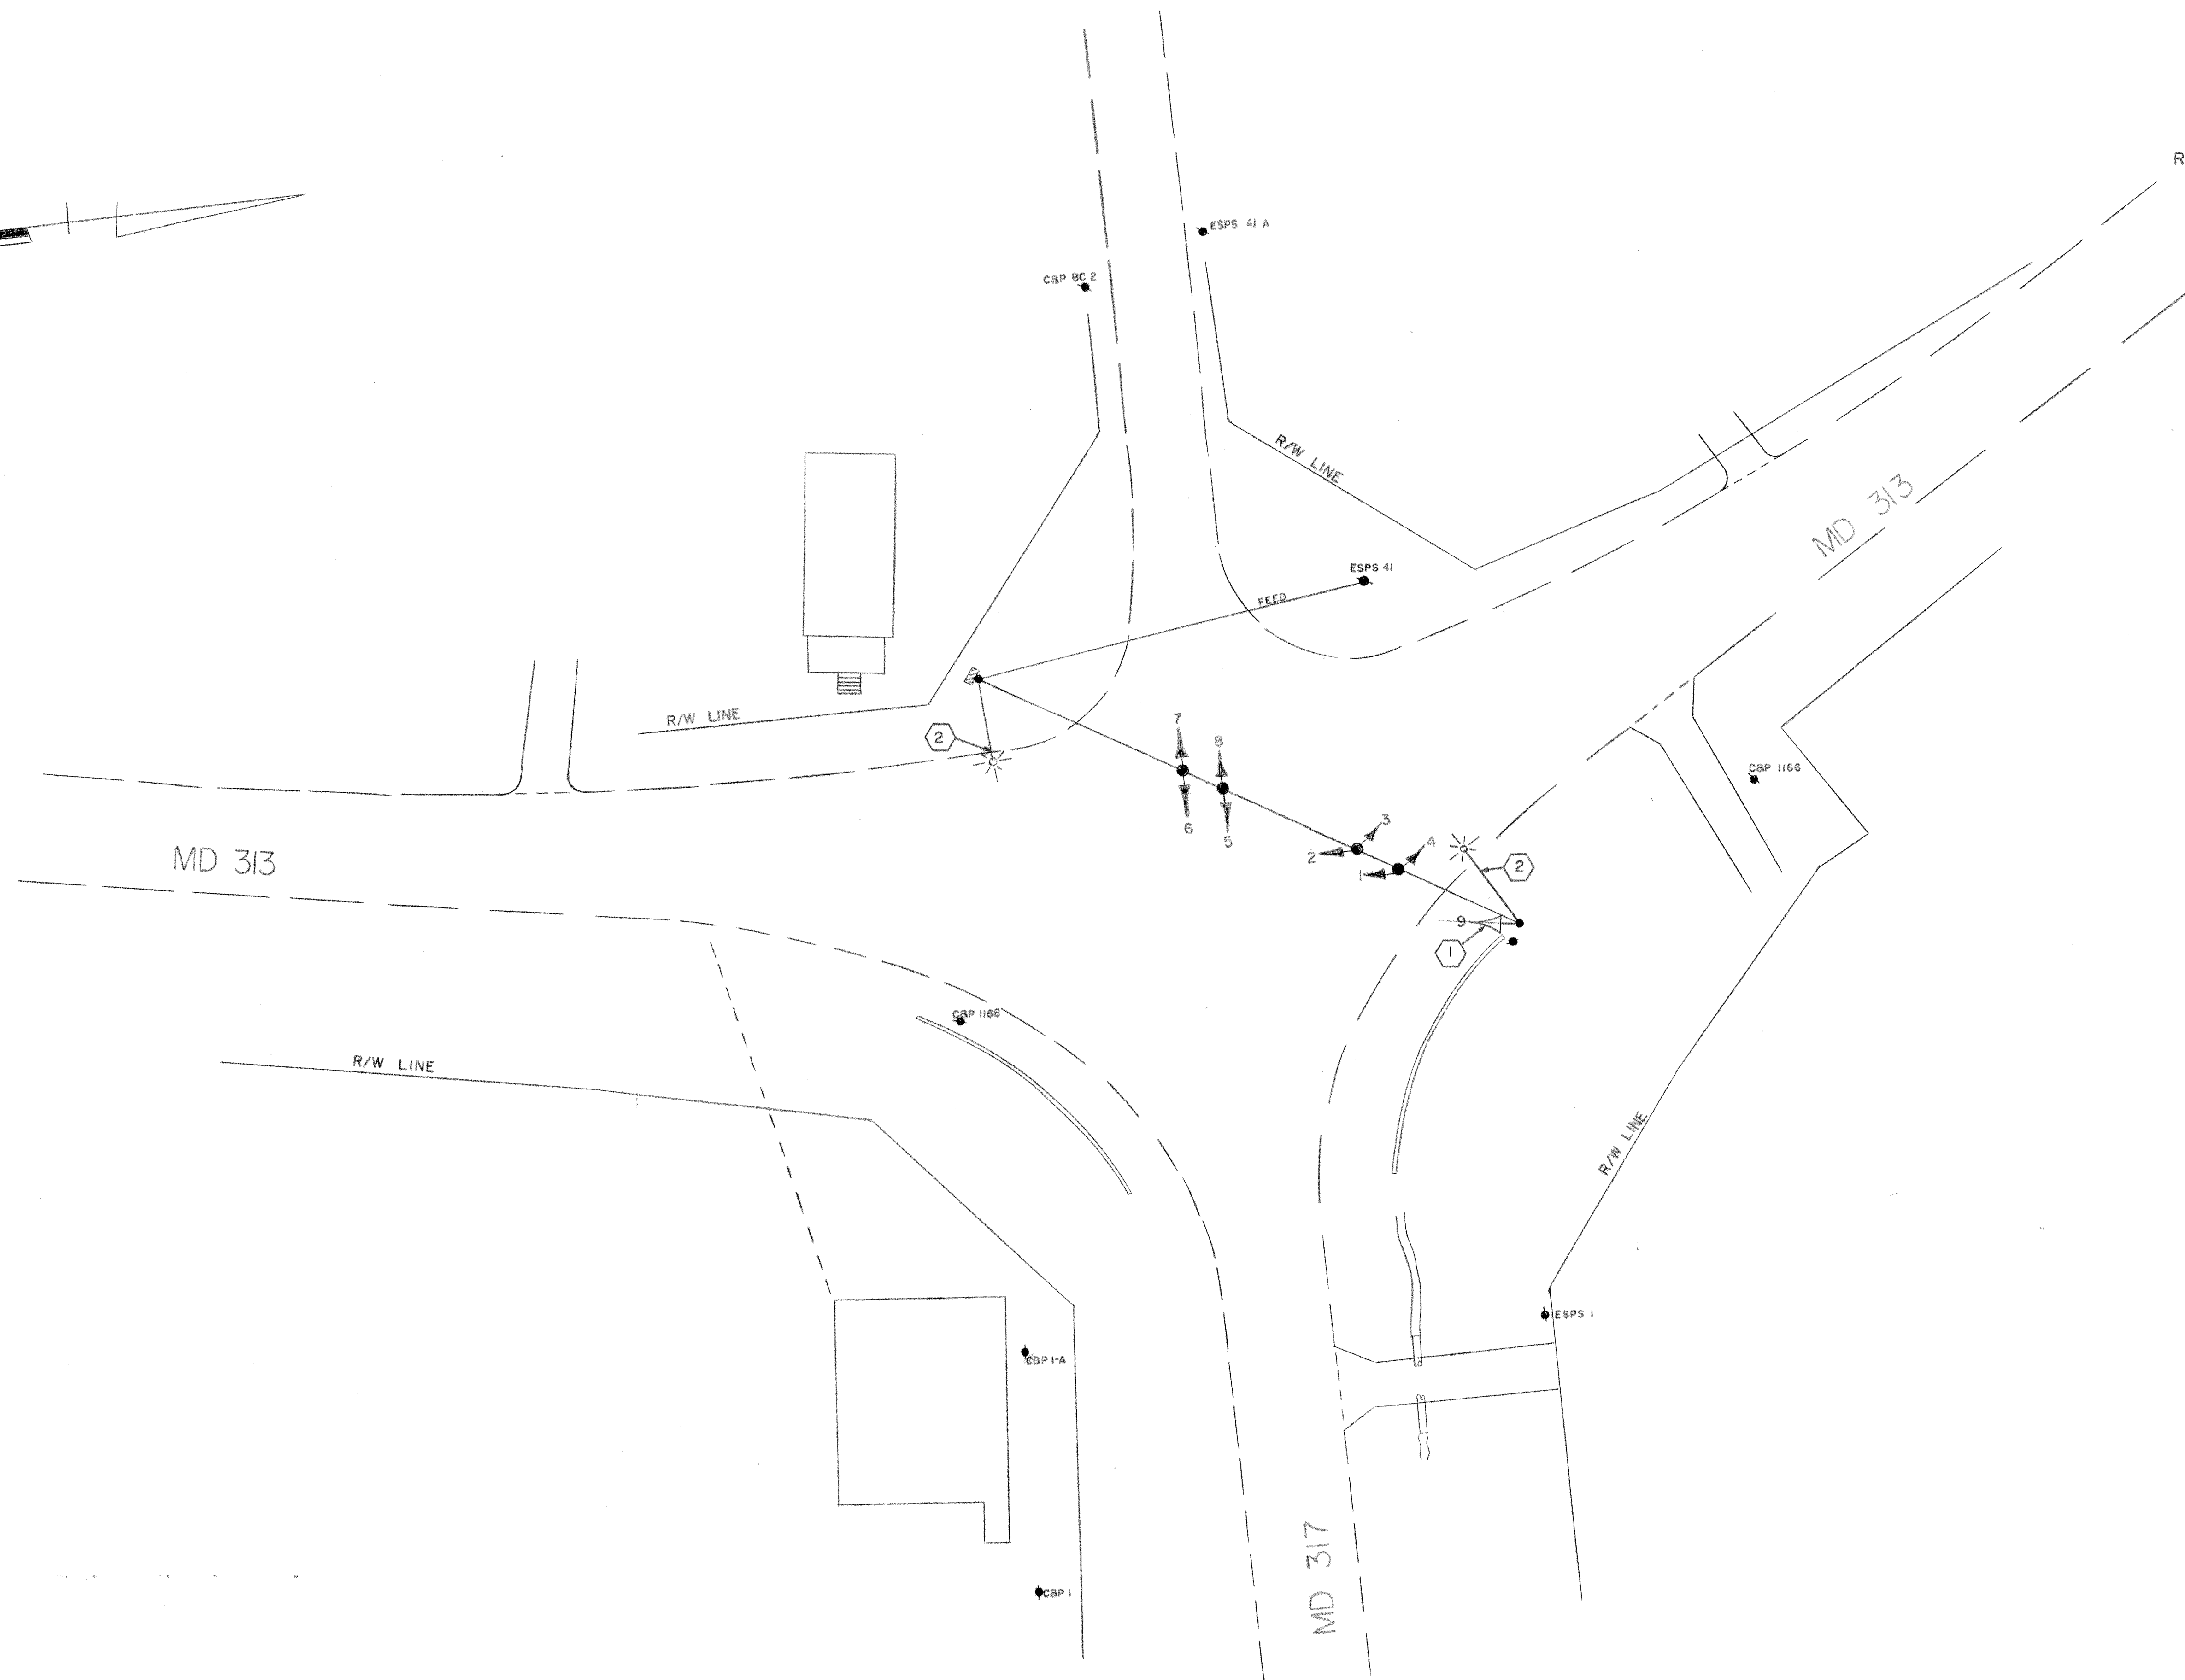


F.H.W.A. REGION NO.	STATE	FED. AID PROJ. NO.	SHEET NO.	TOTAL SHEETS
3	MD.			

SIGNALS
REV. C → 9 (Y) 1-4 (Y) 5-8 (R)

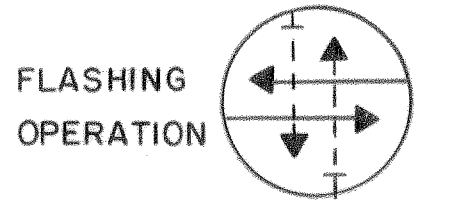

APPROVAL: CHIEF SIGNAL DESIGN SECTION	
APPROVAL: REGIONAL TRAFFIC ENGINEER	5-19-93 INSTALL 3 RD SIG. HD., NB MD 313 & ST. LIGHTING
APPROVAL: CHIEF-BUREAU OF TRAFFIC ENGINEERING	DJD B REDRAWN 8-9-82
APPROVAL: ASS'T. CHIEF ENGINEER TRAFFIC	JH A ASBUILT: 12-11-69
	LET REVISIONS

STATE OF MARYLAND
DEPARTMENT OF TRANSPORTATION
STATE HIGHWAY ADMINISTRATION
TRAFFIC DIVISION — BUREAU OF TRAFFIC ENGINEERING

MD 313 & MD 317

SCALE 1" = 20' DATE 8-9-82 CONTRACT NO.

DRAWN BY: J HOYAS LET COUNTY: CAROLINE

DESIGNED BY: SIGNAL NO.: 05102

CHECKED BY: DRAWING NO. TS- 65 C